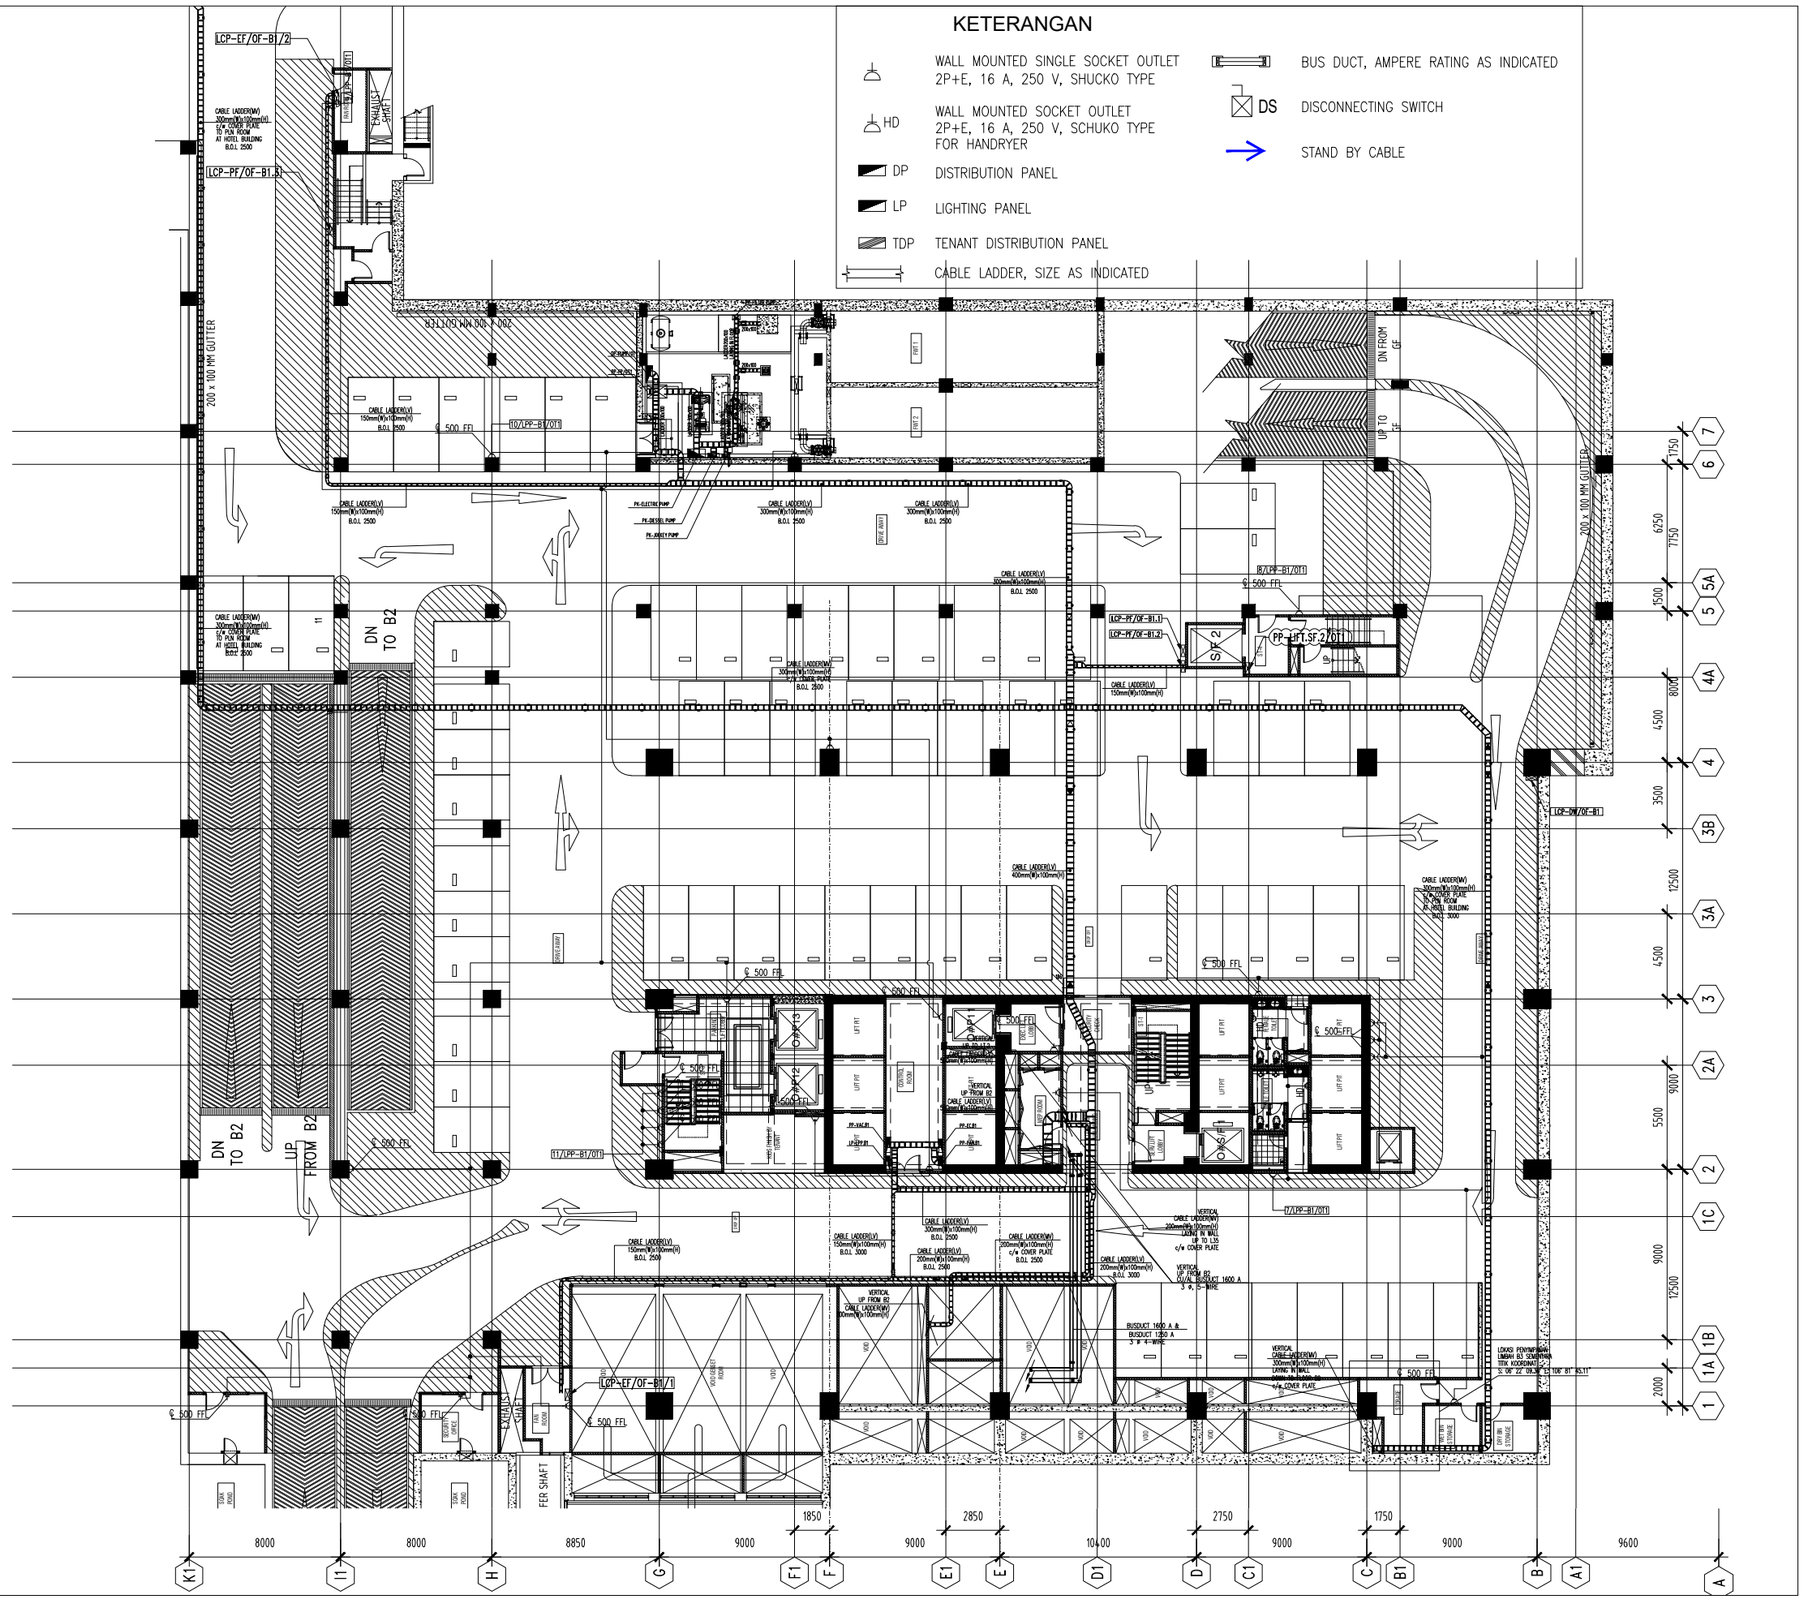

NAMA PROYEK

MANGKULUHUR CITY

KEYPLAN

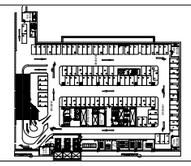

CLIENT — PEMBERI TUGAS

PT. WISMA PURNAYUDHAPUTRA
dan PT. PRABU BUDI MULIA QQ
PT. KENCANA GRAHA OPTIMA

DESIGN ARCHITECT — DISAIN ARSITEKTUR

DP ARCHITECTS PTE LTD
6 RAFFLES BOULEVARD
#04-100 MARINA SQUARE
SINGAPORE 039594
TEL 63383988 FAX 63379989

ARCHITECTURAL — ARSITEKTUR

PTI ARCHITECTS
Level 5, WTC Building
Jl. Jend. Sudirman Kav 29-31 Jakarta 12920
Phone : (62-21) 570 2702
Fax : (62-21) 570 4451
E-mail : pti@pti-architects.com

STRUCTURE — STRUKTUR

PT. HAERTE WIDYA KONSULTAN
KOMPLEK PURI NIAGA
JL. PURI KENCANA BLOK K-7/No.11U JAKARTA 11610
PHONE (62-21)5823078-5823079 FAX (021)5823077

MEP ENGINEERS — MEKANIKAL & ELEKTRIKAL

PT. ARNAN PRATAMA CONSULTANTS
MECHANICAL & ELECTRICAL ENGINEERING CONSULTANTS
Ruko Taman Meruya Blok M No.53A Meruya Utara, Kembangan - Jakarta 11620
Pone : (62) (21) 584-3858 , 584-3859 , Fax : (62) (21) 582-4766, E-mail : arnapratama@cbn.net.id & arnaconsultants.co.id

QUANTITY SURVEYORS

LangdonSeah
AN ARCADIS COMPANY

MANAGEMENT CONTRUCTION

PT. BANGUN KARYA PROPERTINDO
INTEGRATED PROJECT MANAGEMENT CONSULTANT

CONTRACTOR

P.T. NUSA RAYA CIPTA
General Contractor
GEDUNG GRHA CIPTA,2nd FLOOR,JL.DJ PANJAITAN NO.40 JKT 13350
PO.BOX NO.6880/JKPRS,TELP.(62-21)8193582,8193326,8199257-FAX(61-21)8193544

CONTRACTOR ME

PT. SINAR ARTA MULIA
MECHANICAL & ELECTRICAL CONTRACTORS AND GENERAL TRADING
KOMPLEK ARTHA GADING NUKA BLOK.G NO.1-3,JL.BOULEVARD ARTHA GADING - JAKARTA UTARA
TELP. (021) 4585455 (HUNTING), FAX : (021) 4522731 E-mail : sinarartamulia@yahoo.co.id

AS BUILT DRAWING

DIGAMBAR	HASAN.W	
DIPERIKSA	ADHI.S	
DIKETAHUI	TONY SARAGIH	

DIPERIKSA PT. NUSA RAYA CIPTA	
MENYETUJUI PT. BANGUN KARYA PROPERTINDO	
MENGETAHUI PT. KENCANA GRAHA OPTIMA	

DRAWING TITLE	SCALE
INSTALASI STOP KONTAK & RAK KABEL BASEMENT 1 OFFICE TOWER 1	1 : 300 A3

NO	REVISI	PRF
01		△
02		△
REF :		

DATE :	REVISI :
01-AGUSTUS-2017	1

DRAWING NO:	LEMBAR
ABD-SAM-EL-OF-1305	1