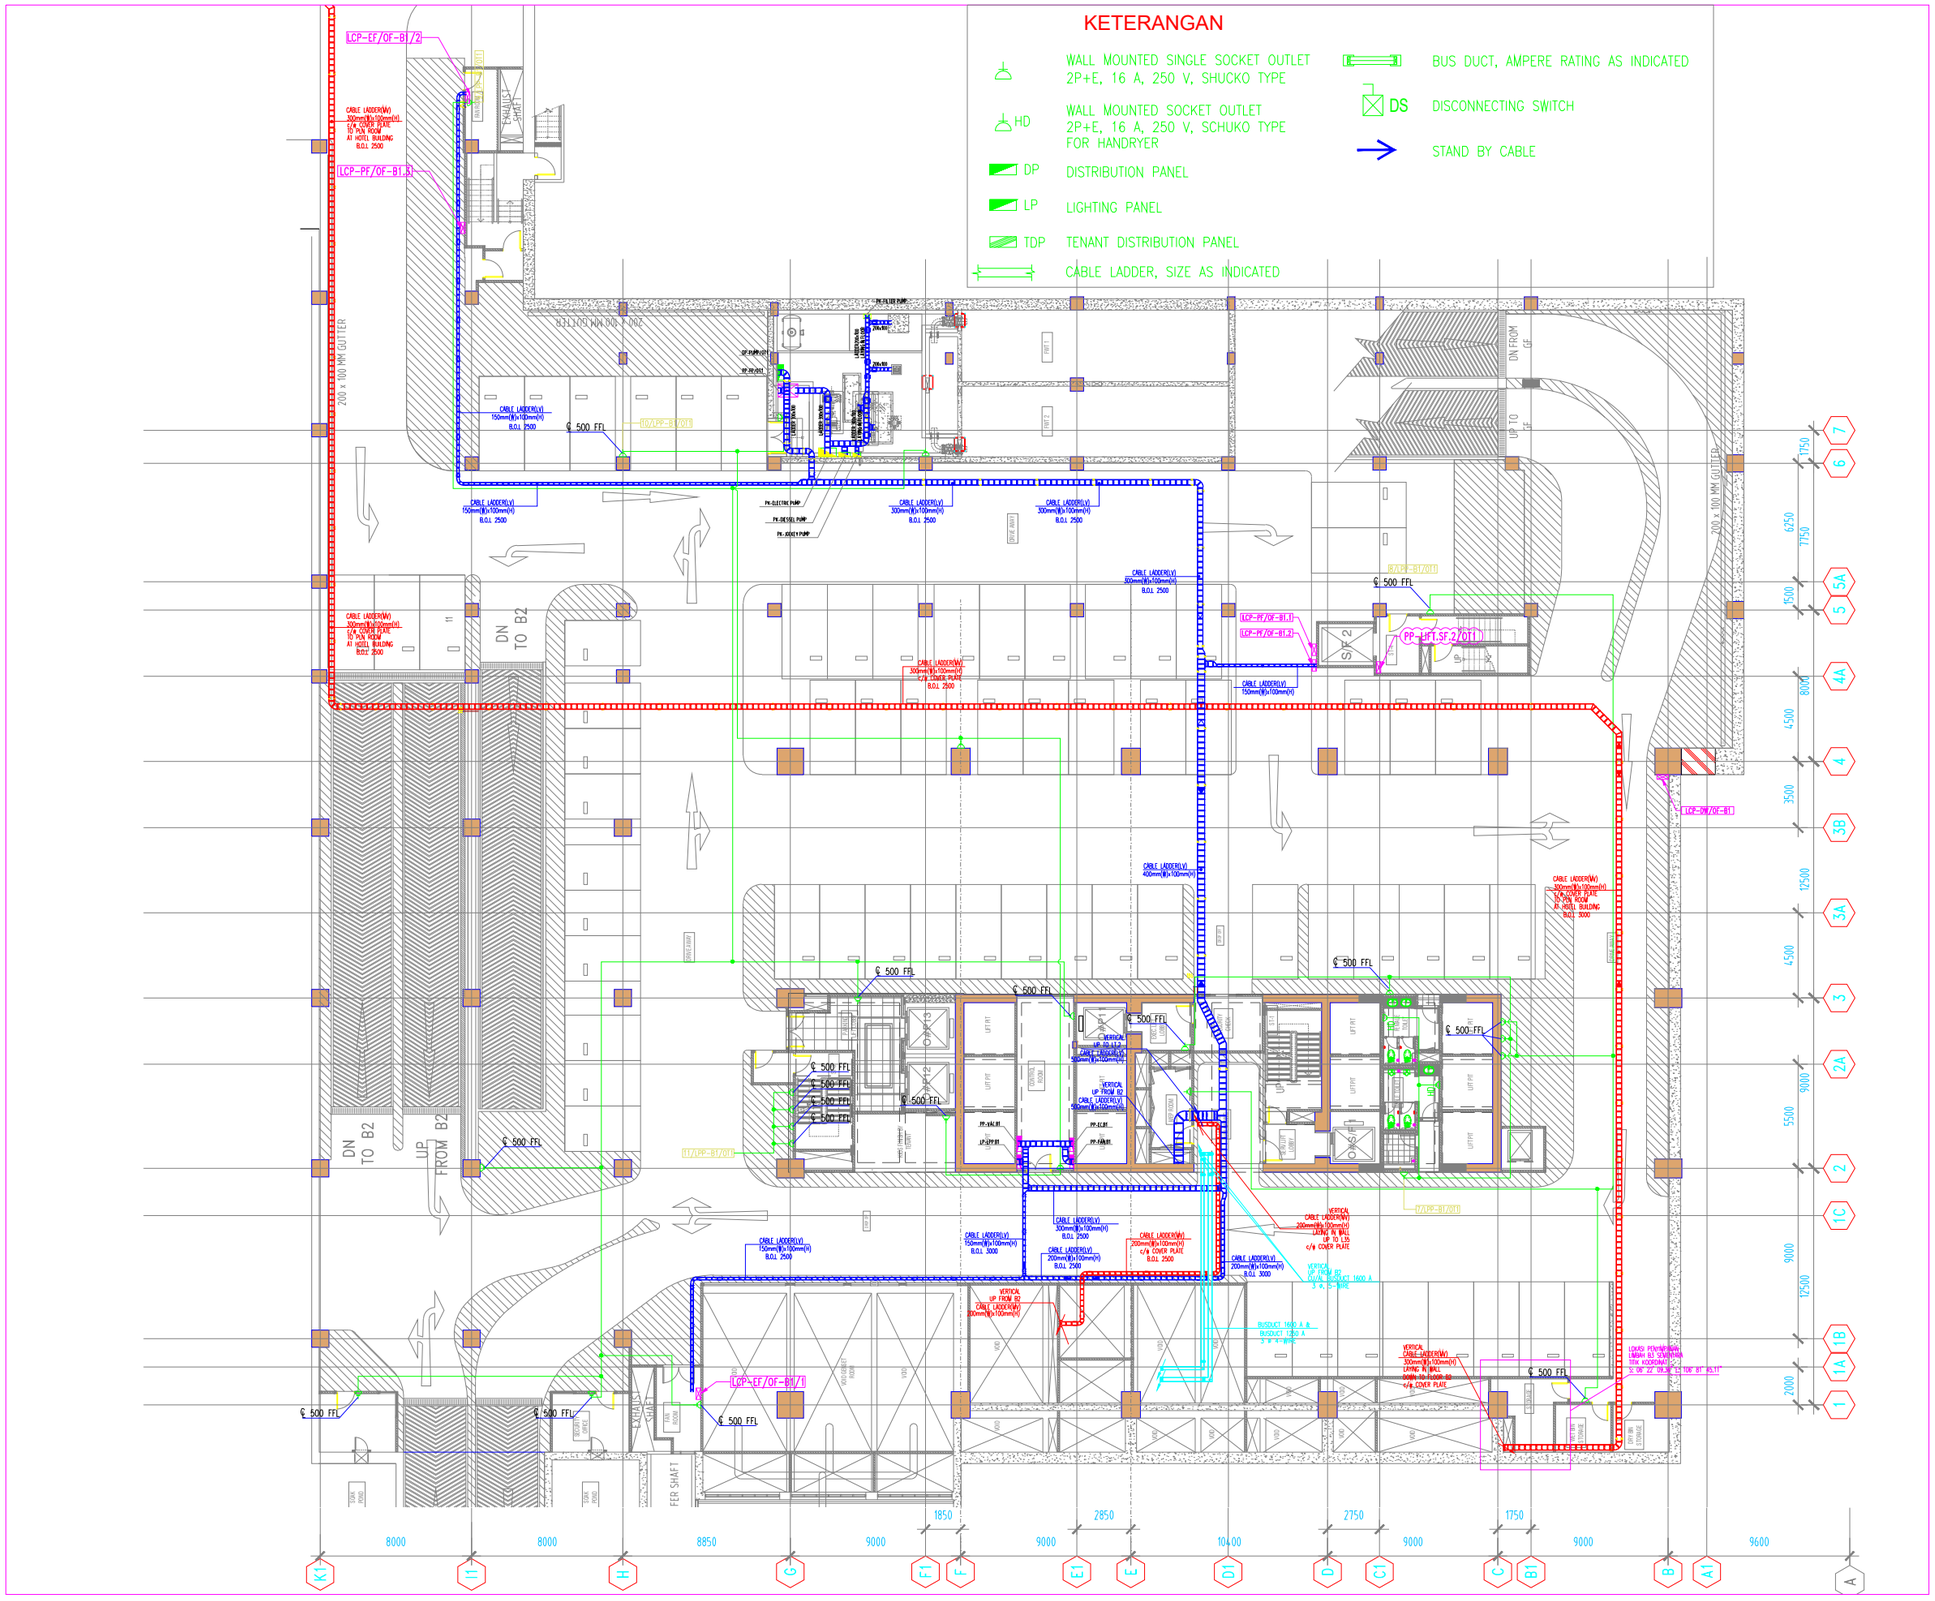

NAMA PROYEK

MANGKULUHUR CITY

KEYPLAN

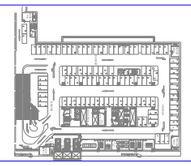

CLIENT — PEMBERI TUGAS

PT. WISMA PURNAYUDHAPUTRA
dan PT. PRABU BUDI MULIA QQ
PT. KENCANA GRAHA OPTIMA

DESIGN ARCHITECT — DISAIN ARSITEKTUR

DP ARCHITECTS PTE LTD
6 RAFFLES BOULEVARD
#04-100 MARINA SQUARE
SINGAPORE 039594
TEL 63383888 : FAX 63379280

ARCHITECTURAL — ARSITEKTUR

PTI ARCHITECTS
Jl. Prof. Dr. Soepomo No. 29-31 Jakarta 12920
Phone : (62-21) 829 2702
Fax : (62-21) 570 4451
E-mail : pti@pti-architects.com

STRUCTURE — STRUKTUR

PT. HAERTE WIDYA KONSULTAN
KOMPLEK PURI NIAGA
JL. PURI KENCANA BLOK K-7/No.1U JAKARTA 11610
PHONE (62-21)5823078-5823079 FAX (021)5823077

MEP ENGINEERS — MEKANIKAL & ELEKTRIKAL

PT. ARNAN PRATAMA CONSULTANTS
MECHANICAL & ELECTRICAL ENGINEERING CONSULTANTS
Bisnis Center Mangga Dua M No 15A Mangga Dua, Pademangan - Jakarta 11420
Phone : (62-21) 584-2888 , 584-2889 , Fax : (62-21) 584-4766, E-mails : arnapratama@cbn.net.id @ arnapratama@cbn.net.id

QUANTITY SURVEYORS

LangdonSeah
AN ARCADIS COMPANY

MANAGEMENT CONTRUCTION

PT. BANGUN KARYA PROPERTIND
INTEGRATED PROJECT MANAGEMENT CONSULTANT

CONTRACTOR

P.T. NUSA RAYA CIPTA
General Contractor
NUSA RAYA CIPTA
GEDUNG GERMA CIPTA LANTAI 7 JL. DR. SUPRAPTO NO. 40 JAKARTA 10250
PO.BOX NO.6800/JKPPS.JSUR.(62-21)8193002,8193026,8193023-7 FAX (61-21)8193044

CONTRACTOR ME

PT. SINAR ARTA MULIA
MECHANICAL & ELECTRICAL CONTRACTORS AND GENERAL TRADING
KOMPLEK ARTHA GADING NUNGA BLOK G NO.1-3, JL.BOULEVARD ARTHA GADING - JAKARTA UTARA
TELP. : (021) 4585-4455 (HUNTING), FAX : (021) 4522733 E-mail : sinartamulia@yahoo.co.id

AS BUILT DRAWING

DIGAMBAR	HASAN.W	
DIPERIKSA	ADHI.S	
DIKETAHUI	TONY SARAGIH	

DIPERIKSA PT. NUSA RAYA CIPTA	
MENYETUJUI PT. BANGUN KARYA PROPERTINDO	
MENGETAHUI PT. KENCANA GRAHA OPTIMA	

DRAWING TITLE	SCALE
INSTALASI STOP KONTAK & RAK KABEL BASEMENT 1 OFFICE TOWER 1	1 : 300 A3

NO	REVISI	PRF
01		△
02		△

REF :

DATE : 01-AGUSTUS-2017

REVISI : 1

DRAWING NO: ABD-SAM-EL-OF-1305

LEMBAR 1